





US Army Corps
of Engineers
Jacksonville District

SAFETY ON THIS JOB
DEPENDS ON YOU

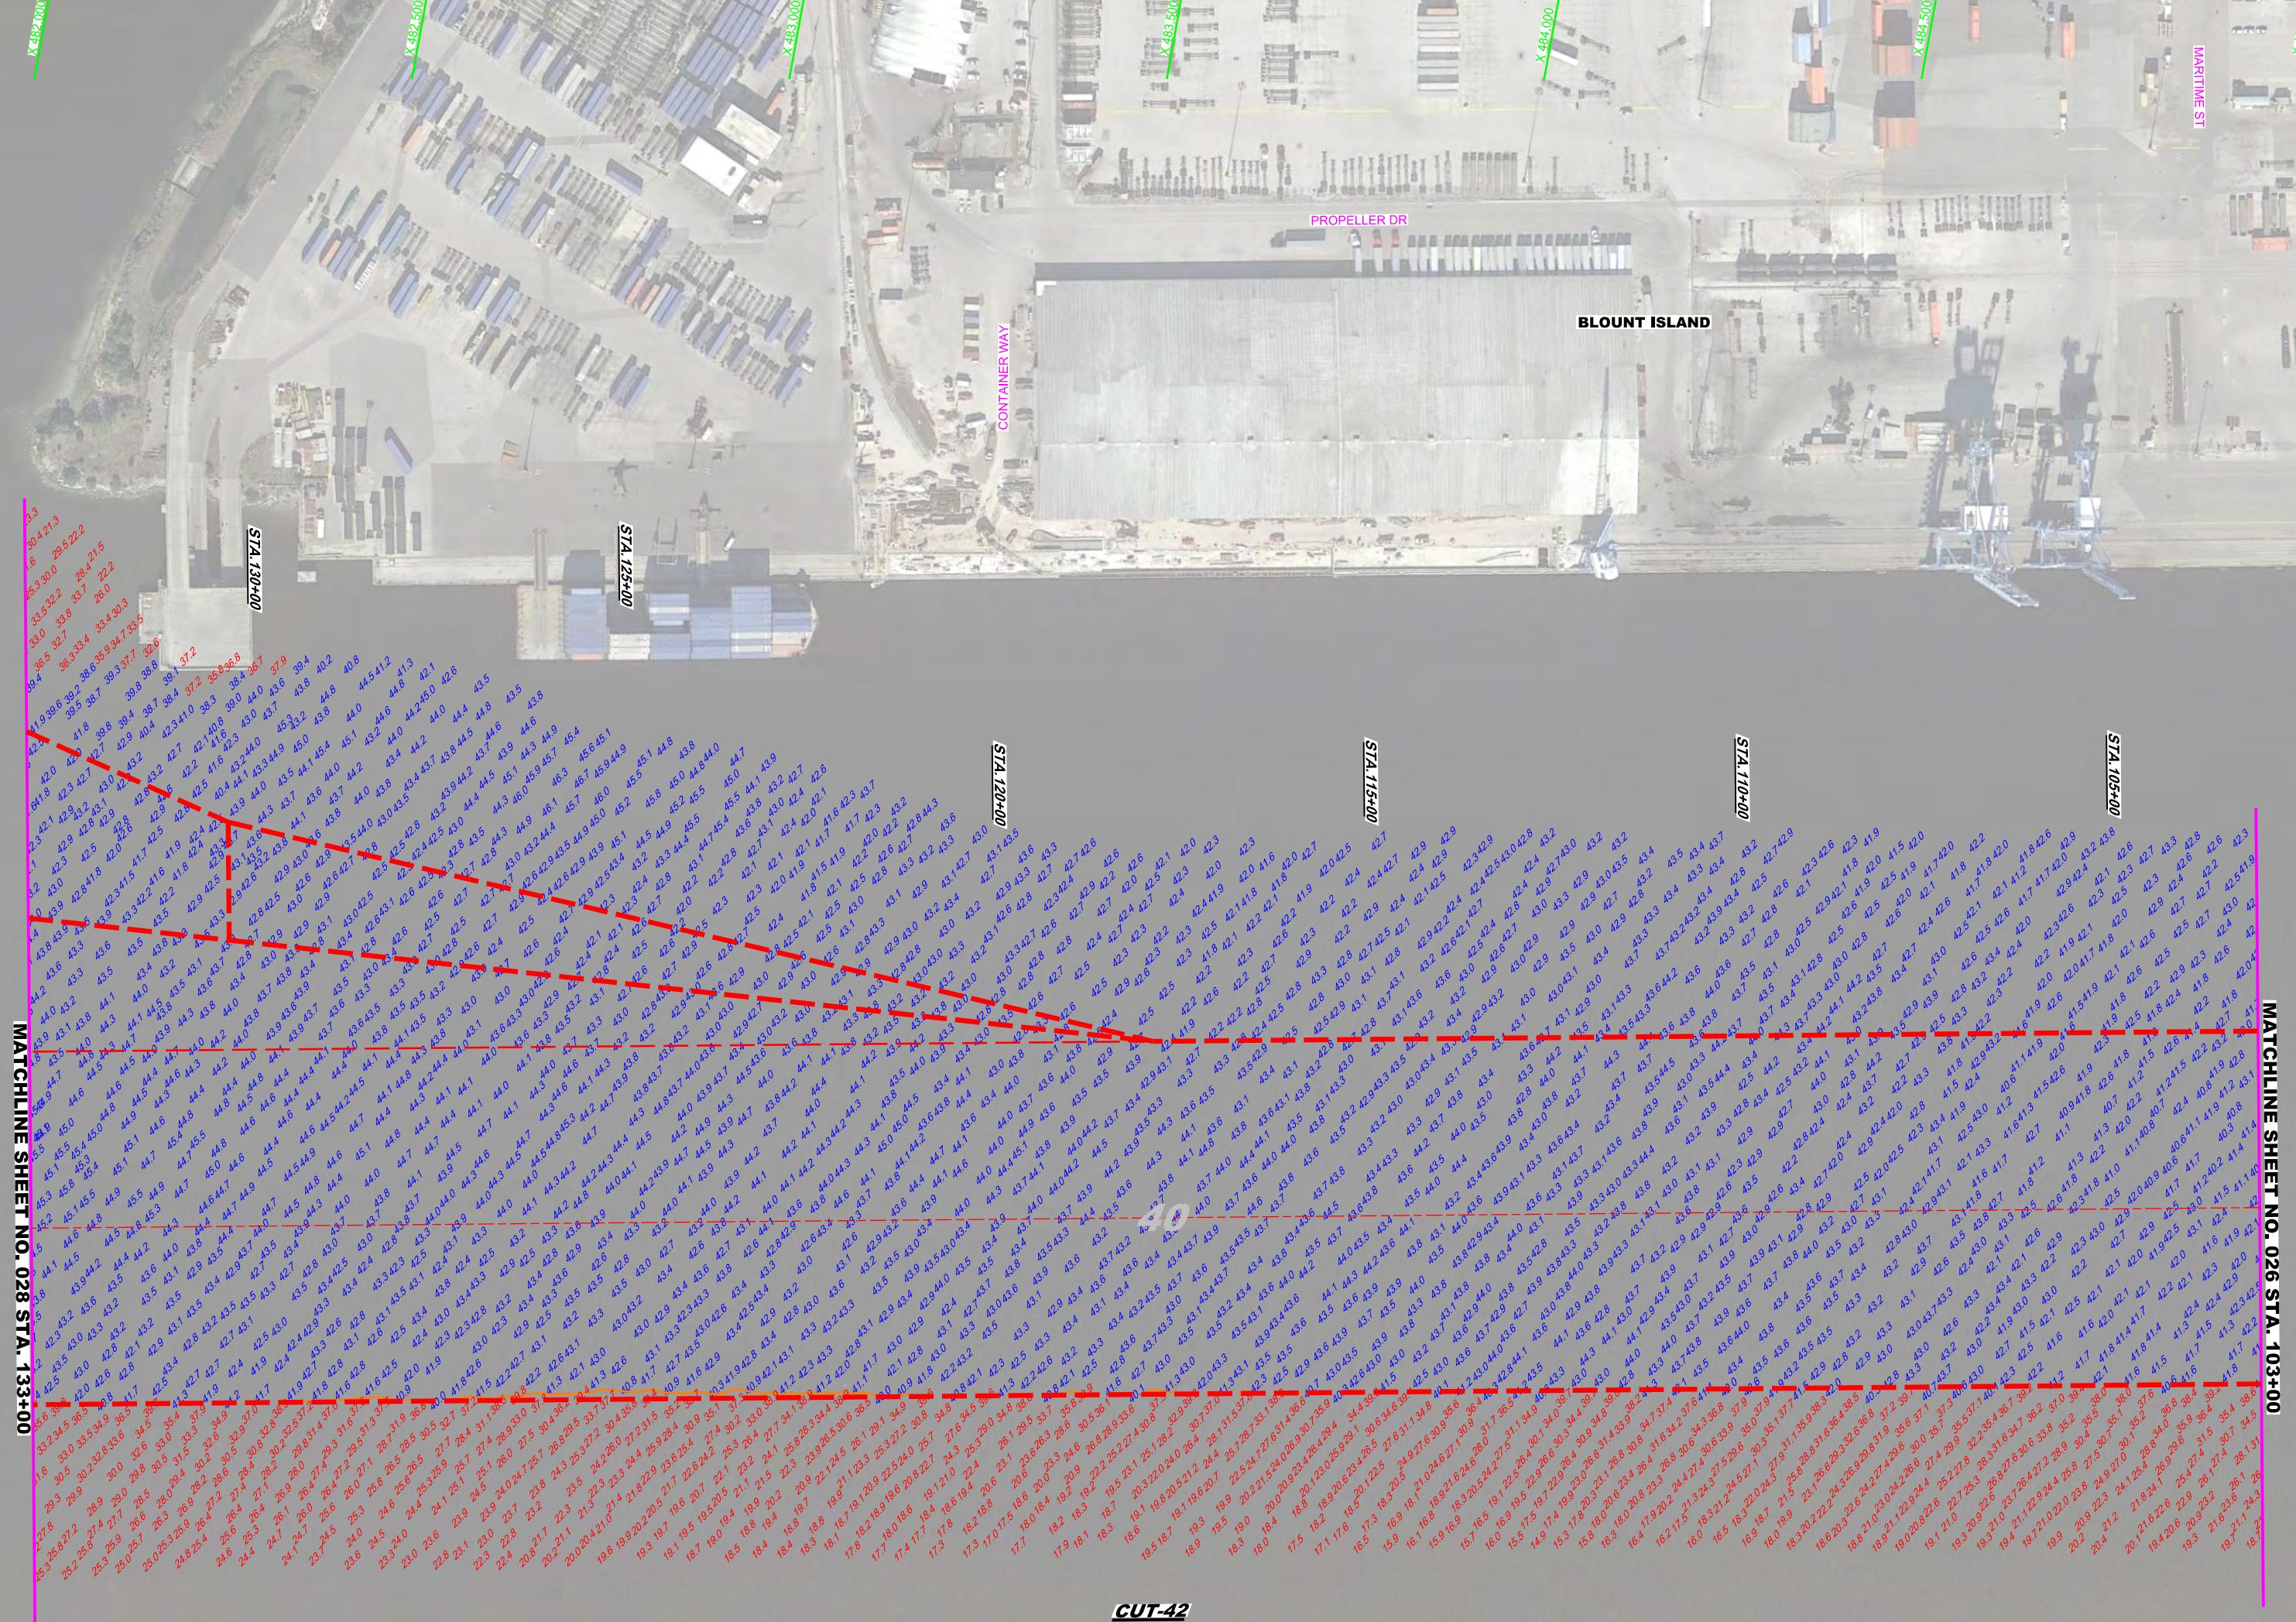

JACKSONVILLE HARBOR, FLORIDA		Designated Dir: WBM	Carried Dir: GR
		Draftsman: WBM	Rev. No.: FEB 2014
		Date: 2014	
DEPARTMENT OF THE ARMY JACKSONVILLE DISTRICT, CORPS OF ENGINEERS JACKSONVILLE, FLORIDA			
RGE - 237.50			
RGE 00			
RGE 00			
RGE 237.50			
PLAN			
ANNUAL EXAMINATION SURVEY FY14 30, 34, 38, 40 & 42-FOOT PROJECT STA 103+00 THRU STA. 133+00 CUT-42			
Scale: AS SHOWN			
Drawing no. 27			
Notes: 1. REFER TO SURVEY NO. 14-001. 2. SEE SHEET NO. 1 FOR SURVEY NOTES.			
Graphic Scale 100' 0' 100' 200'			
Sheet 27 OF 57			

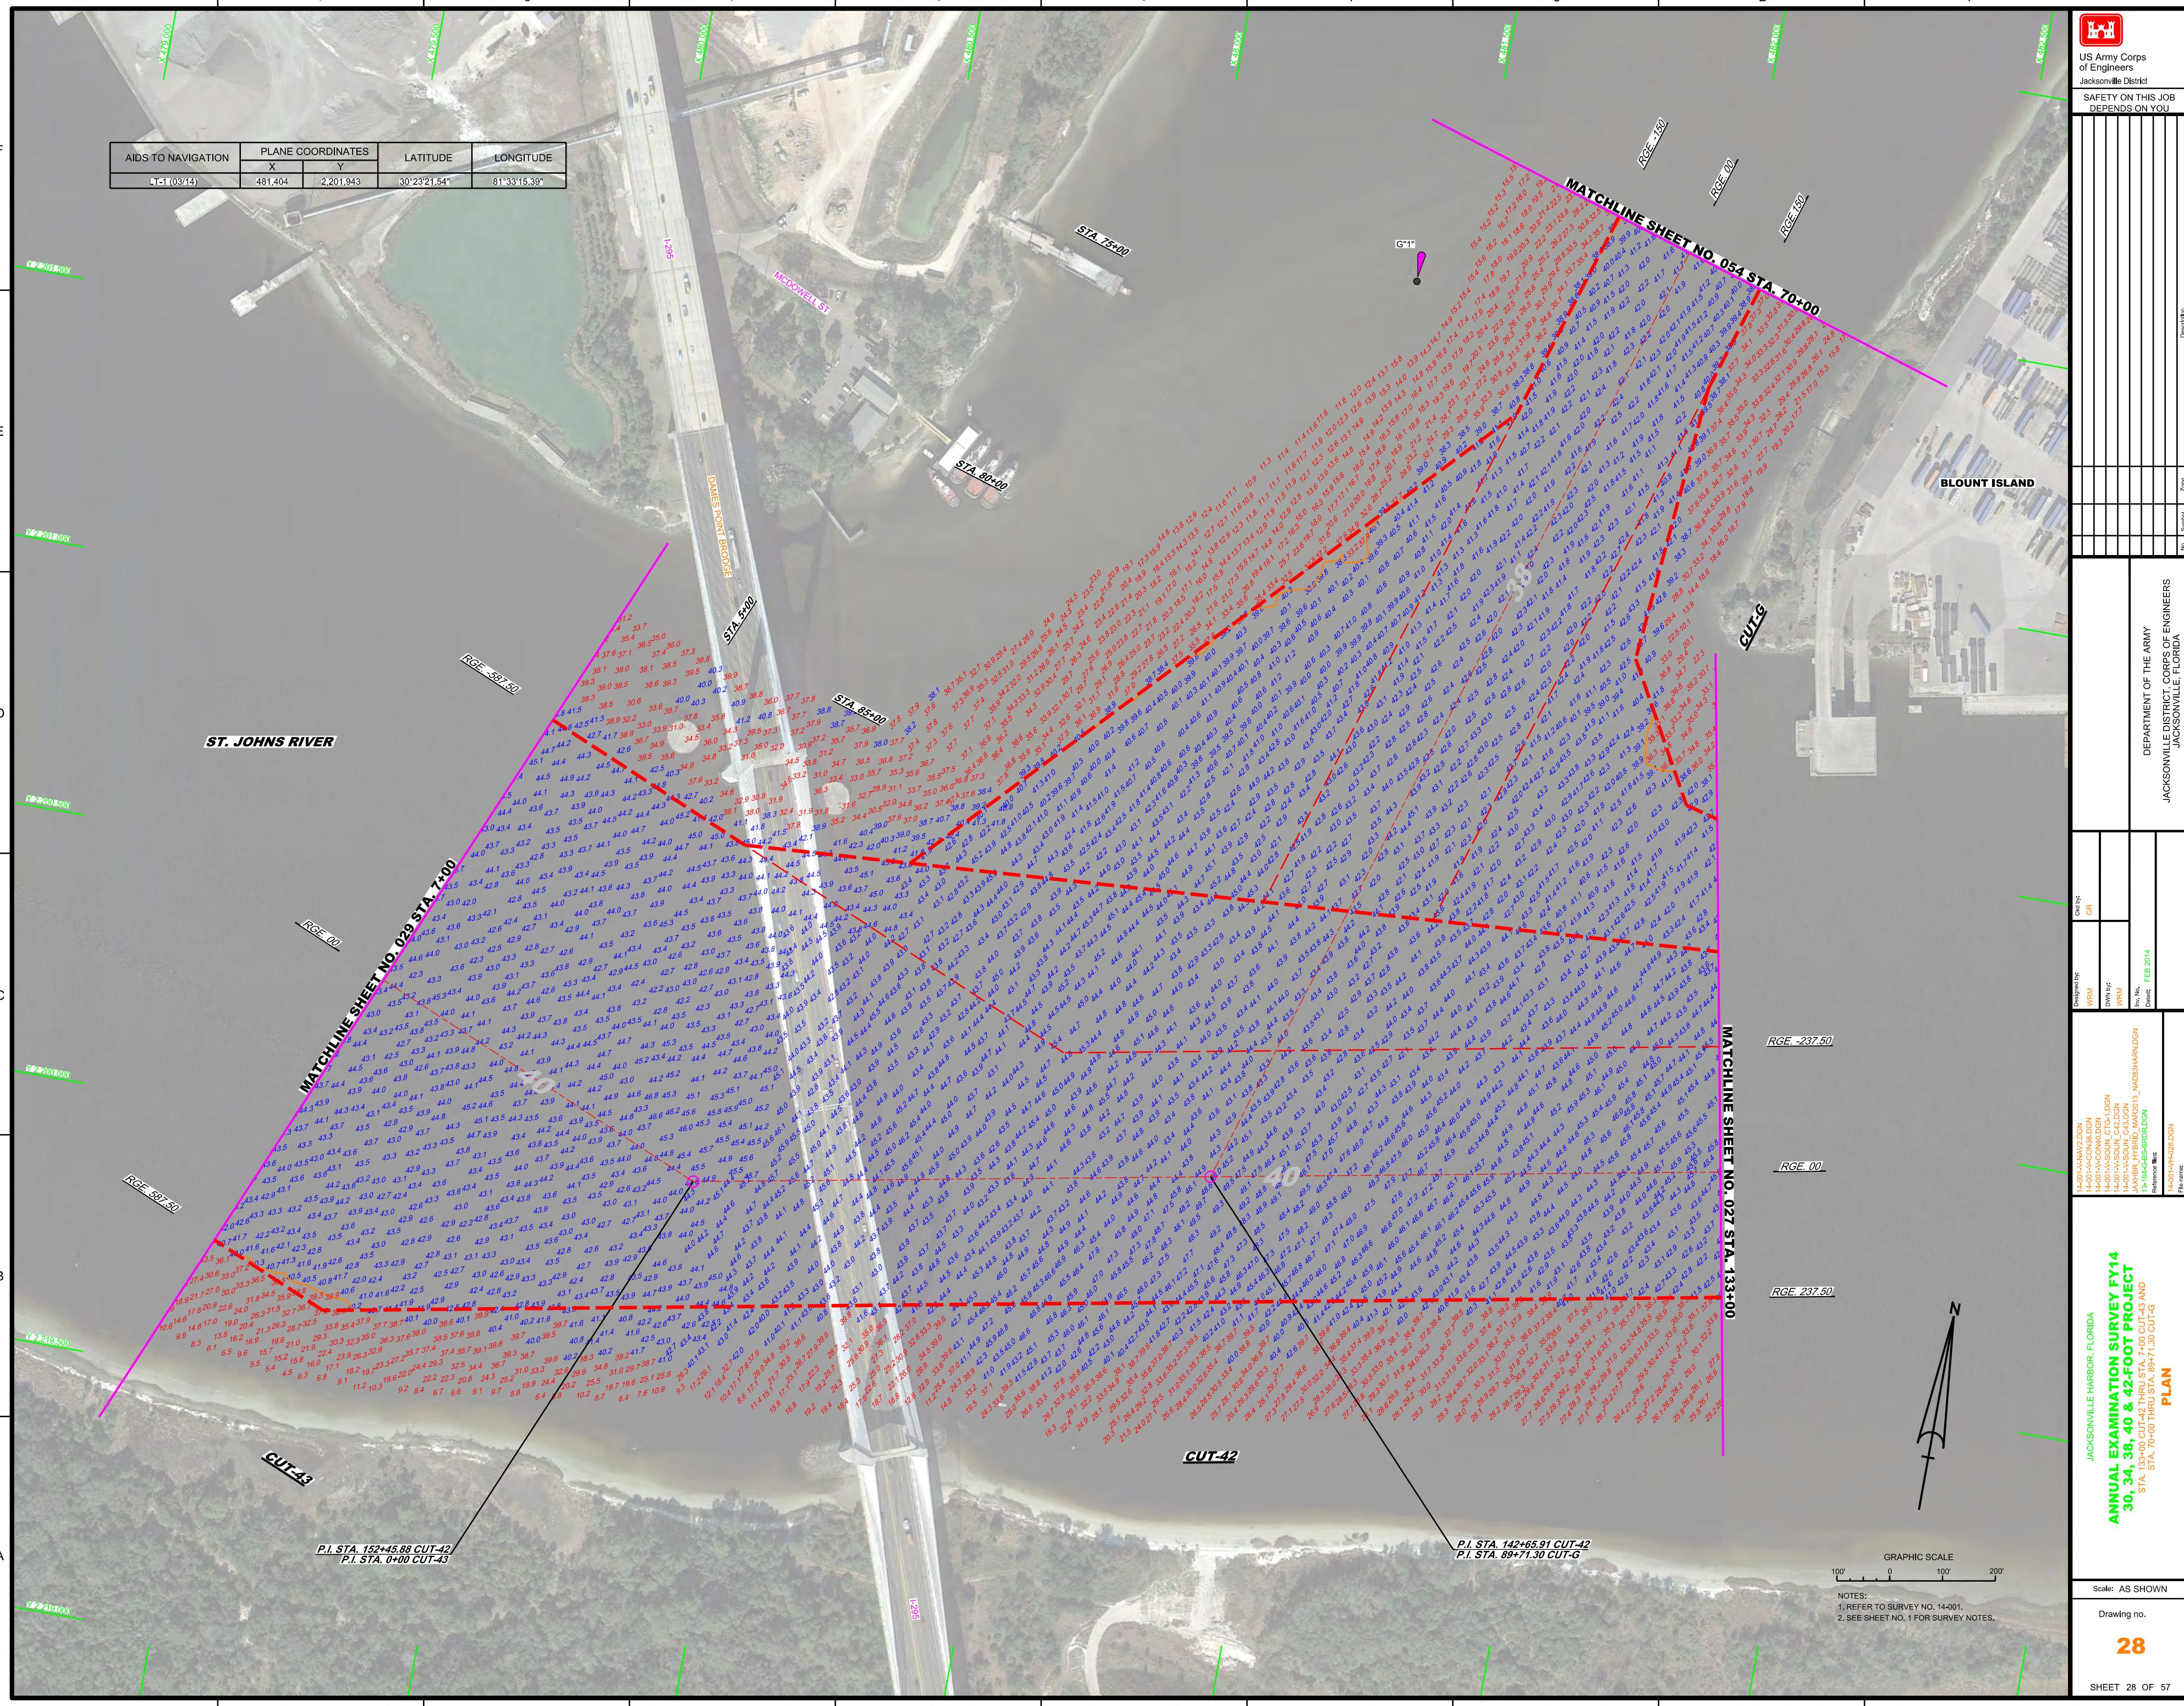



US Army Corps
of Engineers
Jacksonville District

SAFETY ON THIS JOB
DEPENDS ON YOU

MATCHLINE SHEET NO. 30 STA. 13+00

RGE. 262.5
RGE. 00
RGE. 262.5

RGE. VARIES

CUT-44

P.I. STA. 21+57.00 CUT-43
P.I. STA. 0+00 CUT-44

BARTRAM ISLAND

CUT-43

PLAN

JACKSONVILLE HARBOR, FLORIDA
ANNUAL EXAMINATION SURVEY FY14
30, 34, 38, 40 & 42-FOOT PROJECT
STA. 7+00 CUT-43 THRU STA. 13+00 CUT-44

Scale: AS SHOWN
Drawing no.
29

Sheet 29 OF 57

GRAPHIC SCALE
100' 0' 100' 200'

NOTES:
1. REFER TO SURVEY NO. 14-001.
2. SEE SHEET NO. 1 FOR SURVEY NOTES.

Scale: AS SHOWN

Drawing no.

29

Sheet 29 OF 57

No.	Station	Zone	Description
1			
2			
3			
4			
5			
6			
7			
8			
9			
10			

Designated:	Calcs:
WBM	GR

Date:	Year:
FEB 2014	2014


Reference: WBM-120100N
File name: 140701H02100N


DEPARTMENT OF THE ARMY
JACKSONVILLE DISTRICT, CORPS OF ENGINEERS
JACKSONVILLE, FLORIDA



US Army Corps
of Engineers
Jacksonville District

SAFETY ON THIS JOB
DEPENDS ON YOU

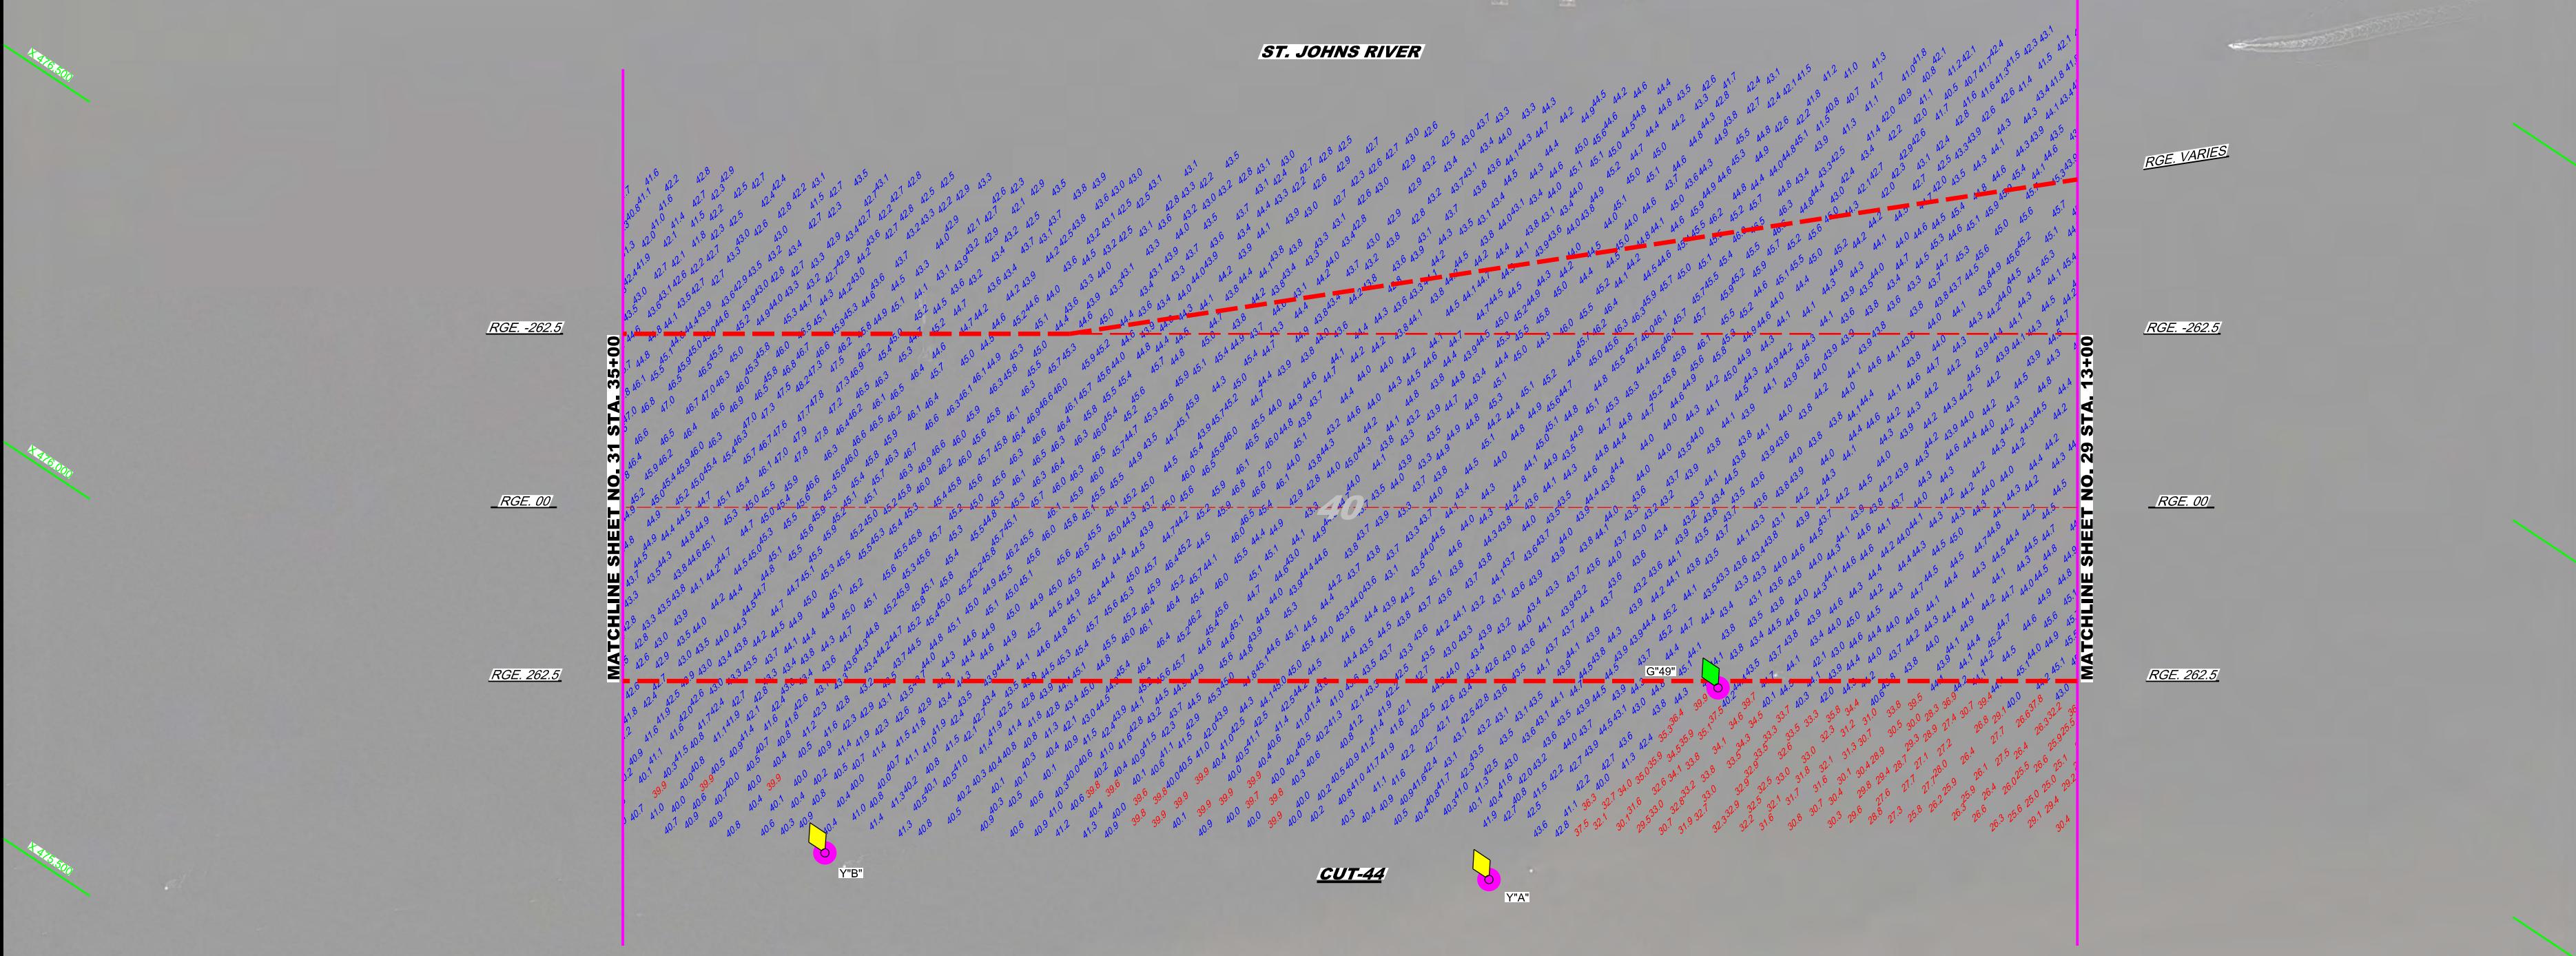

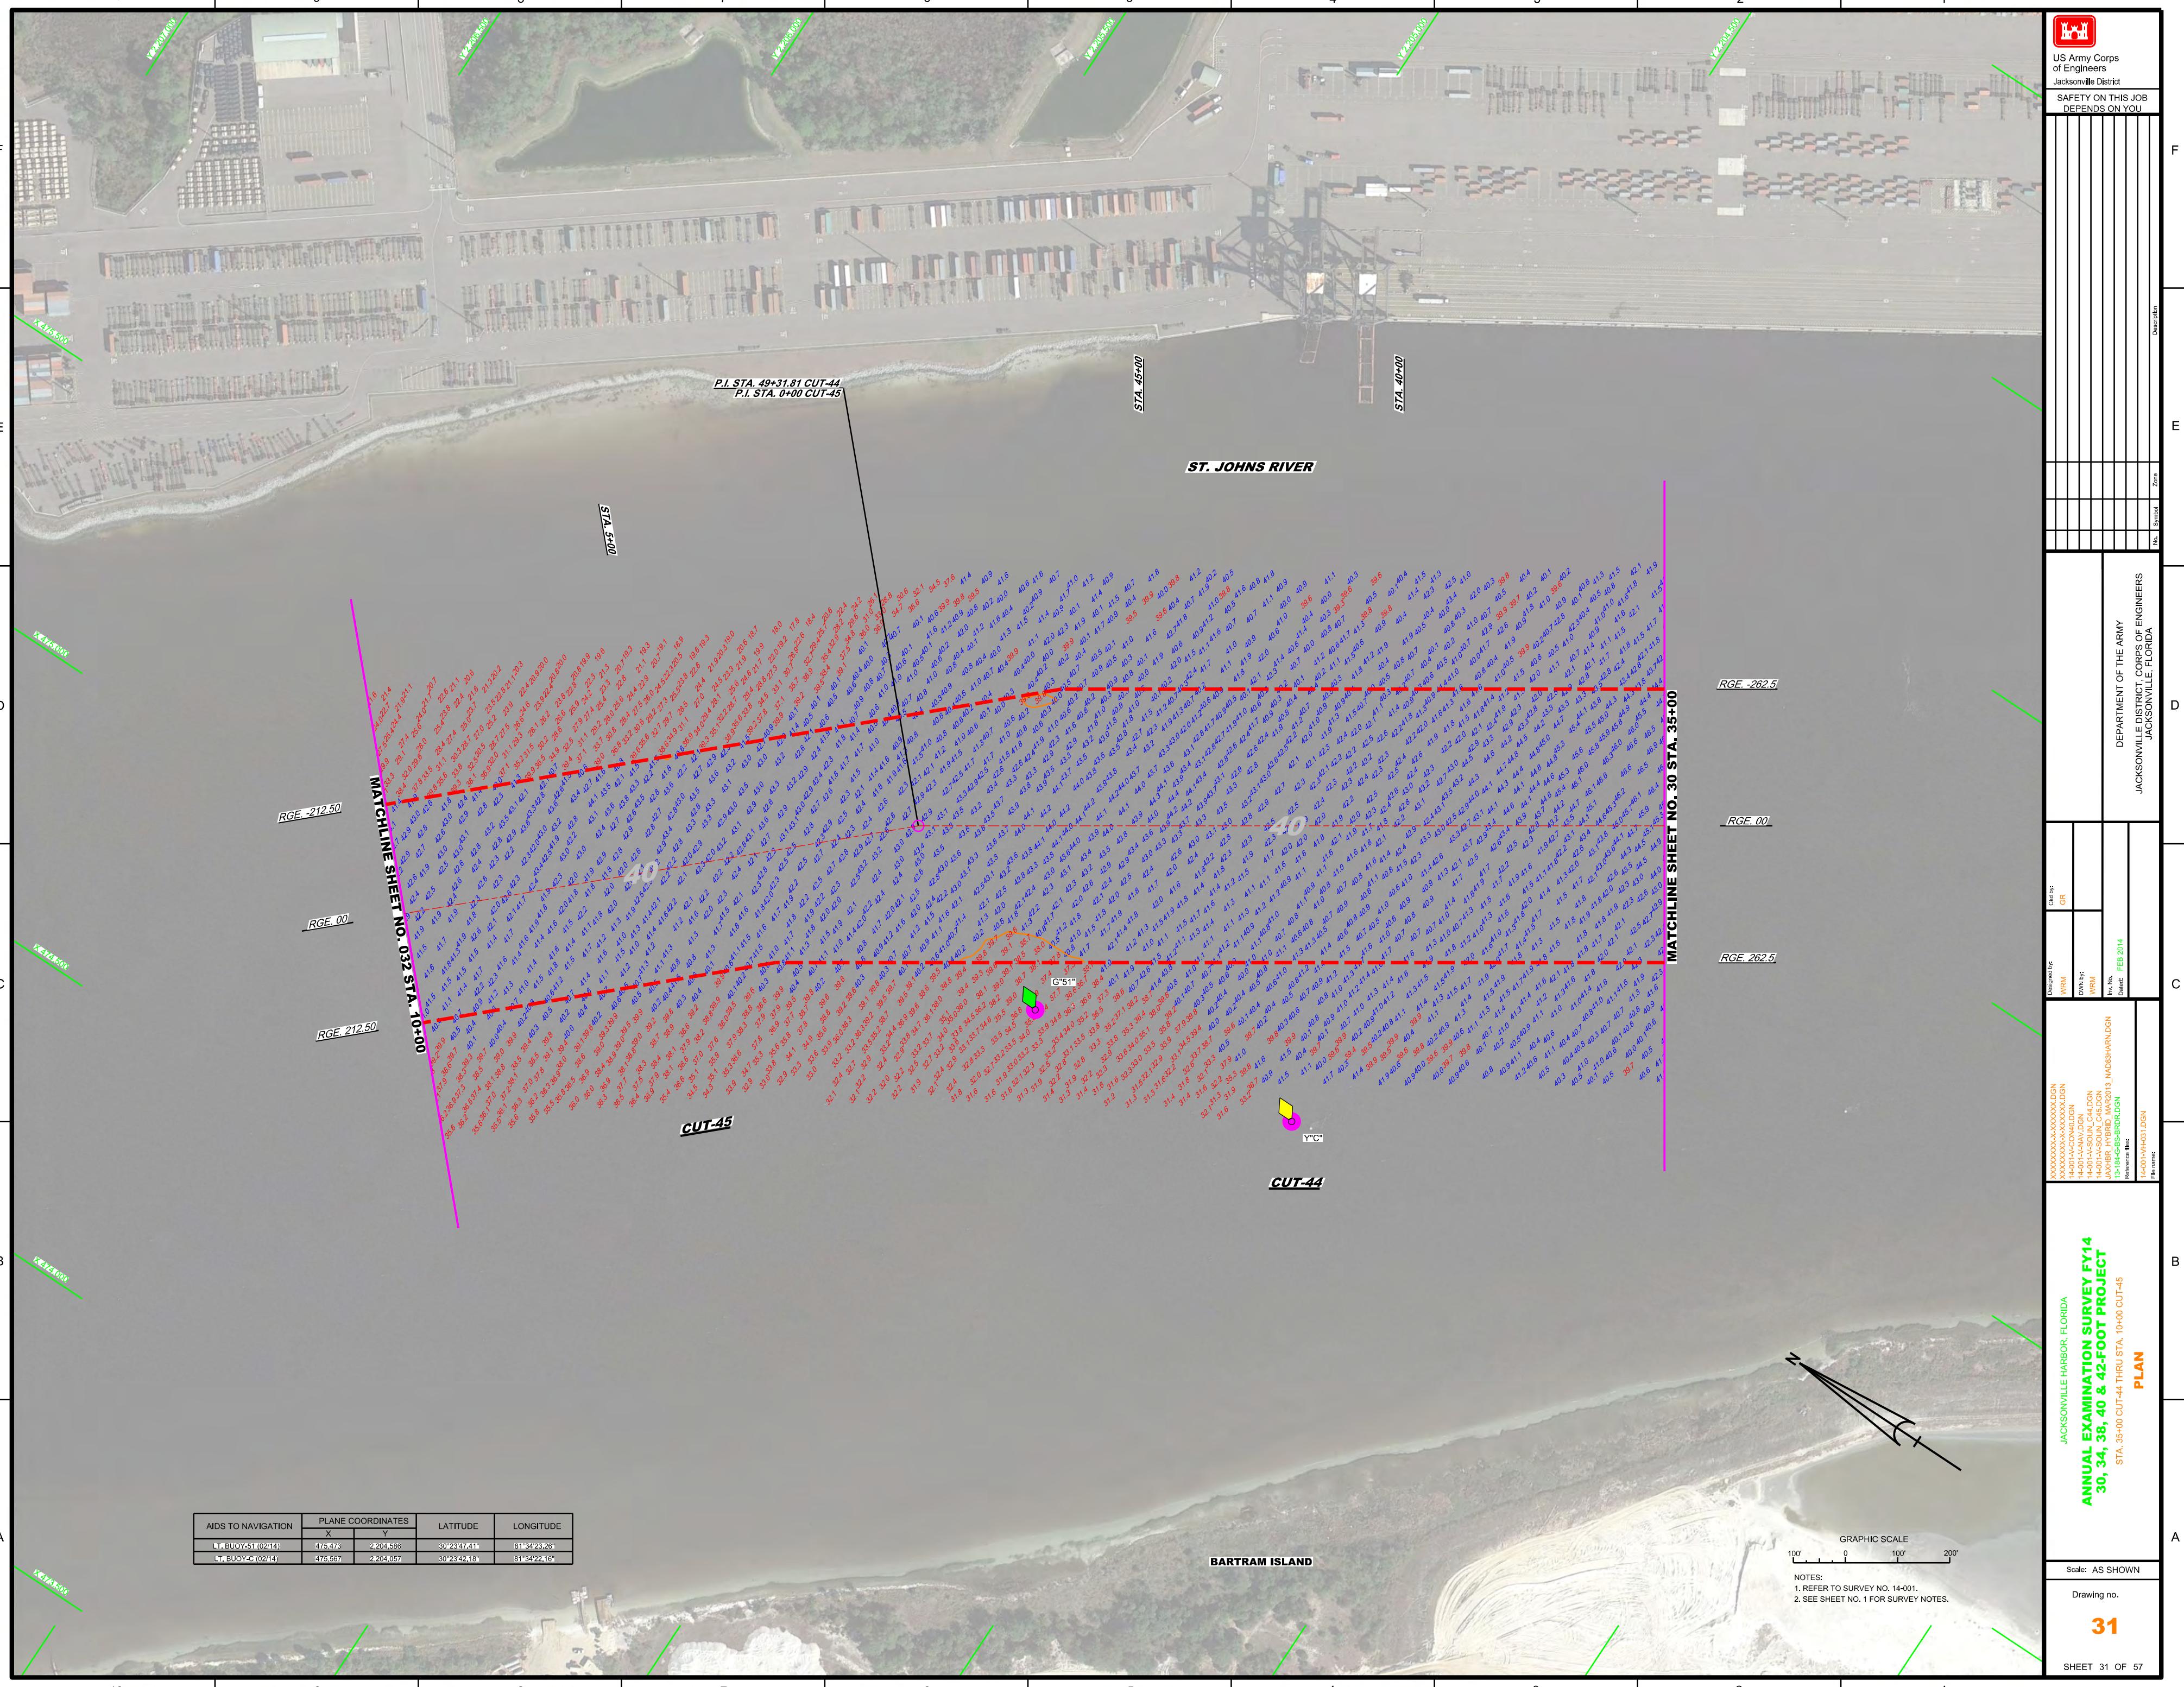



US Army Corps
of Engineers
Jacksonville District

SAFETY ON THIS JOB
DEPENDS ON YOU



MATCHLINE SHEET NO. 033 STA. 39+00

RGE. -212.50
RGE. 00
RGE. 212.50
RGE. VARIES

A series of coordinates listed in two columns, representing survey points along a matchline. The coordinates are in a grid format, with some points highlighted in orange. A red line connects points from RGE. -212.50 to RGE. 00, and another red line connects points from RGE. 00 to RGE. 212.50. A green circle labeled 'G-53' is located near the bottom center of the grid.

CUT-45

ST. JOHNS RIVER

BARTRAM ISLAND

AIDS TO NAVIGATION	PLANE COORDINATES		LATITUDE	LONGITUDE
	X	Y		
LT. BUOY-53 (03/14)	473.162	2,207,184	30°24'13.01"	81°34'49.81"

GRAPHIC SCALE
100' 0' 100' 200'

NOTES:
1. REFER TO SURVEY NO. 14-001.
2. SEE SHEET NO. 1 FOR SURVEY NOTES.

JACKSONVILLE HARBOR, FLORIDA
ANNUAL EXAMINATION SURVEY FY14
30, 34, 38, 40 & 42-FOOT PROJECT
STA. 10+00 THRU STA. 38+00 CUT-45

PLAN

Scale: AS SHOWN

Drawing no.

32

Sheet 32 OF 57

RGE. -212.50
RGE. 00
RGE. 212.50

RGE. -212.50
RGE. 00

XXXXXX-XXXX-XXXX-XXXX-XXXX
XXXXXX-XXXX-XXXX-XXXX-XXXX
14-001-SURVEY-CASENO
JACKSONVILLE, FLORIDA
13-184-28-BID#01-DON
Reference Blk: 100-102.DON
File name: 140714H02.DON

DEPARTMENT OF THE ARMY
JACKSONVILLE DISTRICT, CORPS OF ENGINEERS
JACKSONVILLE, FLORIDA



US Army Corps
of Engineers
Jacksonville District

SAFETY ON THIS JOB
DEPENDS ON YOU

Description

E

JACKSONVILLE DISTRICT, CORPS OF ENGINEERS
JACKSONVILLE, FLORIDA

D

C

B

JACKSONVILLE HARBOR, FLORIDA
ANNUAL EXAMINATION SURVEY FY14
30, 34, 38, 40 & 42-FOOT PROJECT
STA. 39+00 CUT-45 THRU STA. 8+00 CUT-47
PLAN

Scale: AS SHOWN

Drawing no.

33

Sheet 33 OF 57

AIDS TO NAVIGATION		PLANE COORDINATES		LATITUDE	LONGITUDE
	X	Y			
LT, BUOY-55 (02/14)	471,118	2,208,865	30°24'29.55"	81°35'13.24"	


GRAPHIC SCALE
100' 0' 100' 200'
NOTES:
1. REFER TO SURVEY NO. 144001.
2. SEE SHEET NO. 1 FOR SURVEY NOTES.


Scale: AS SHOWN

Drawing no.

33

Sheet 33 OF 57

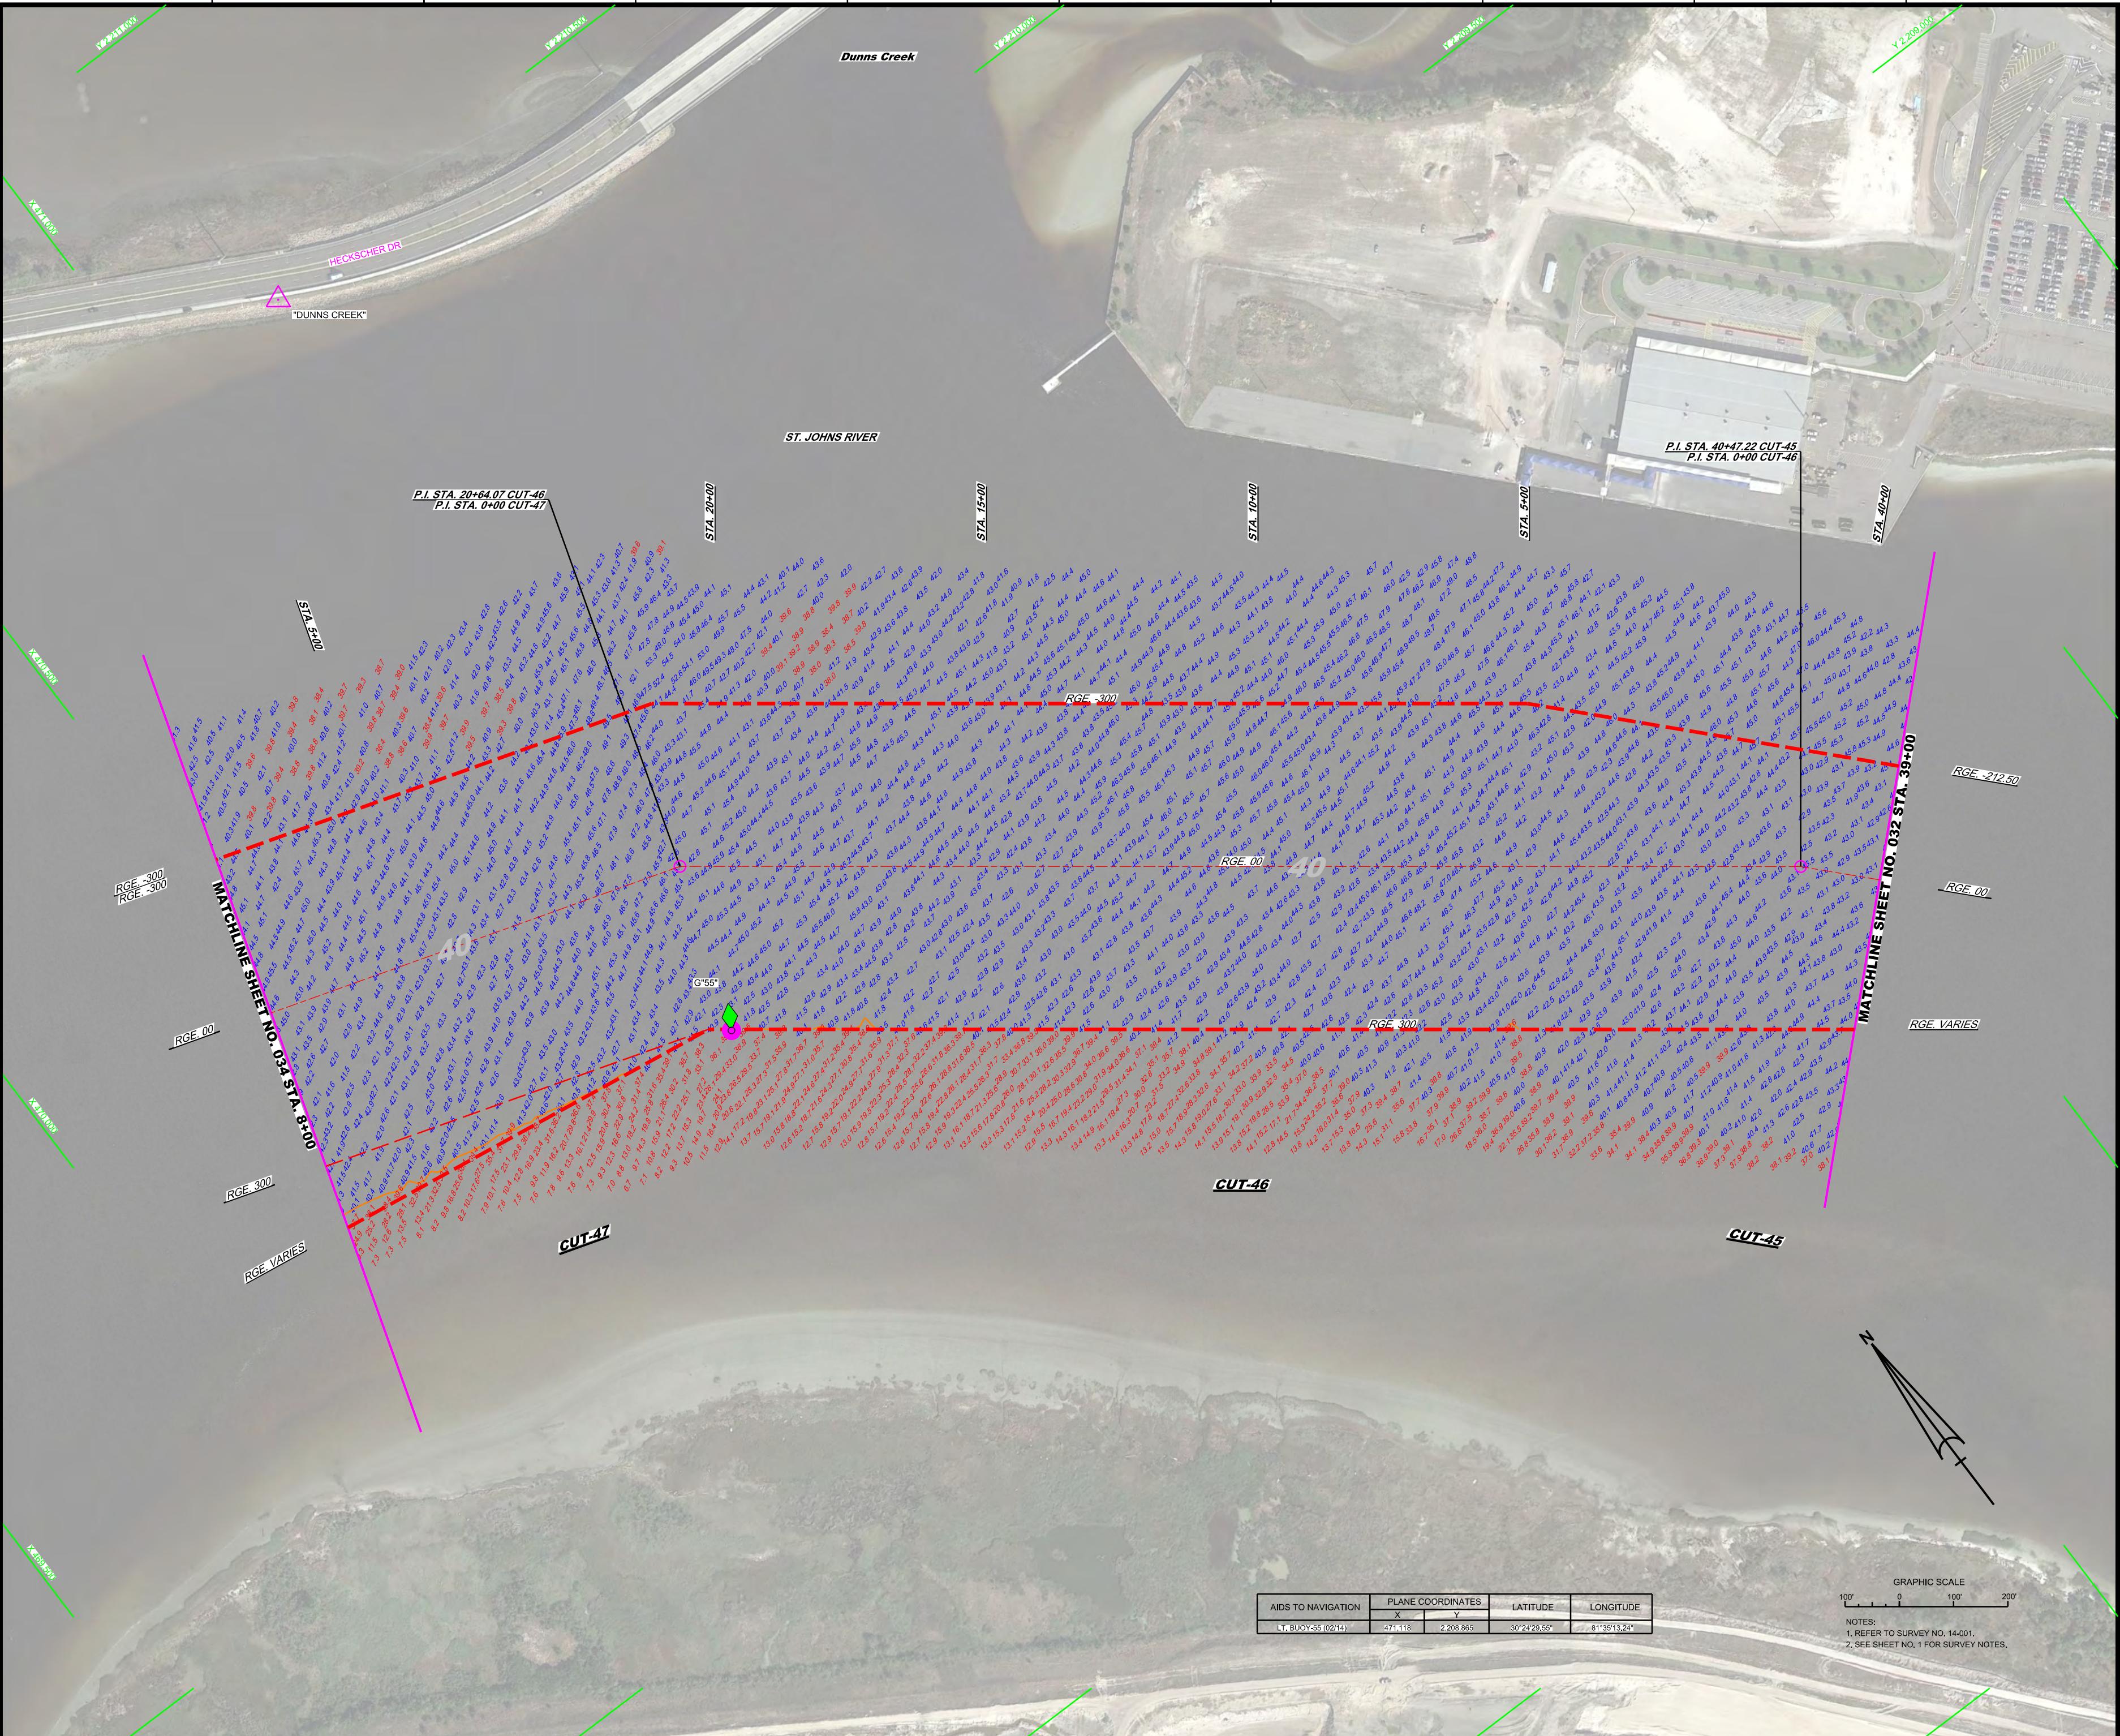


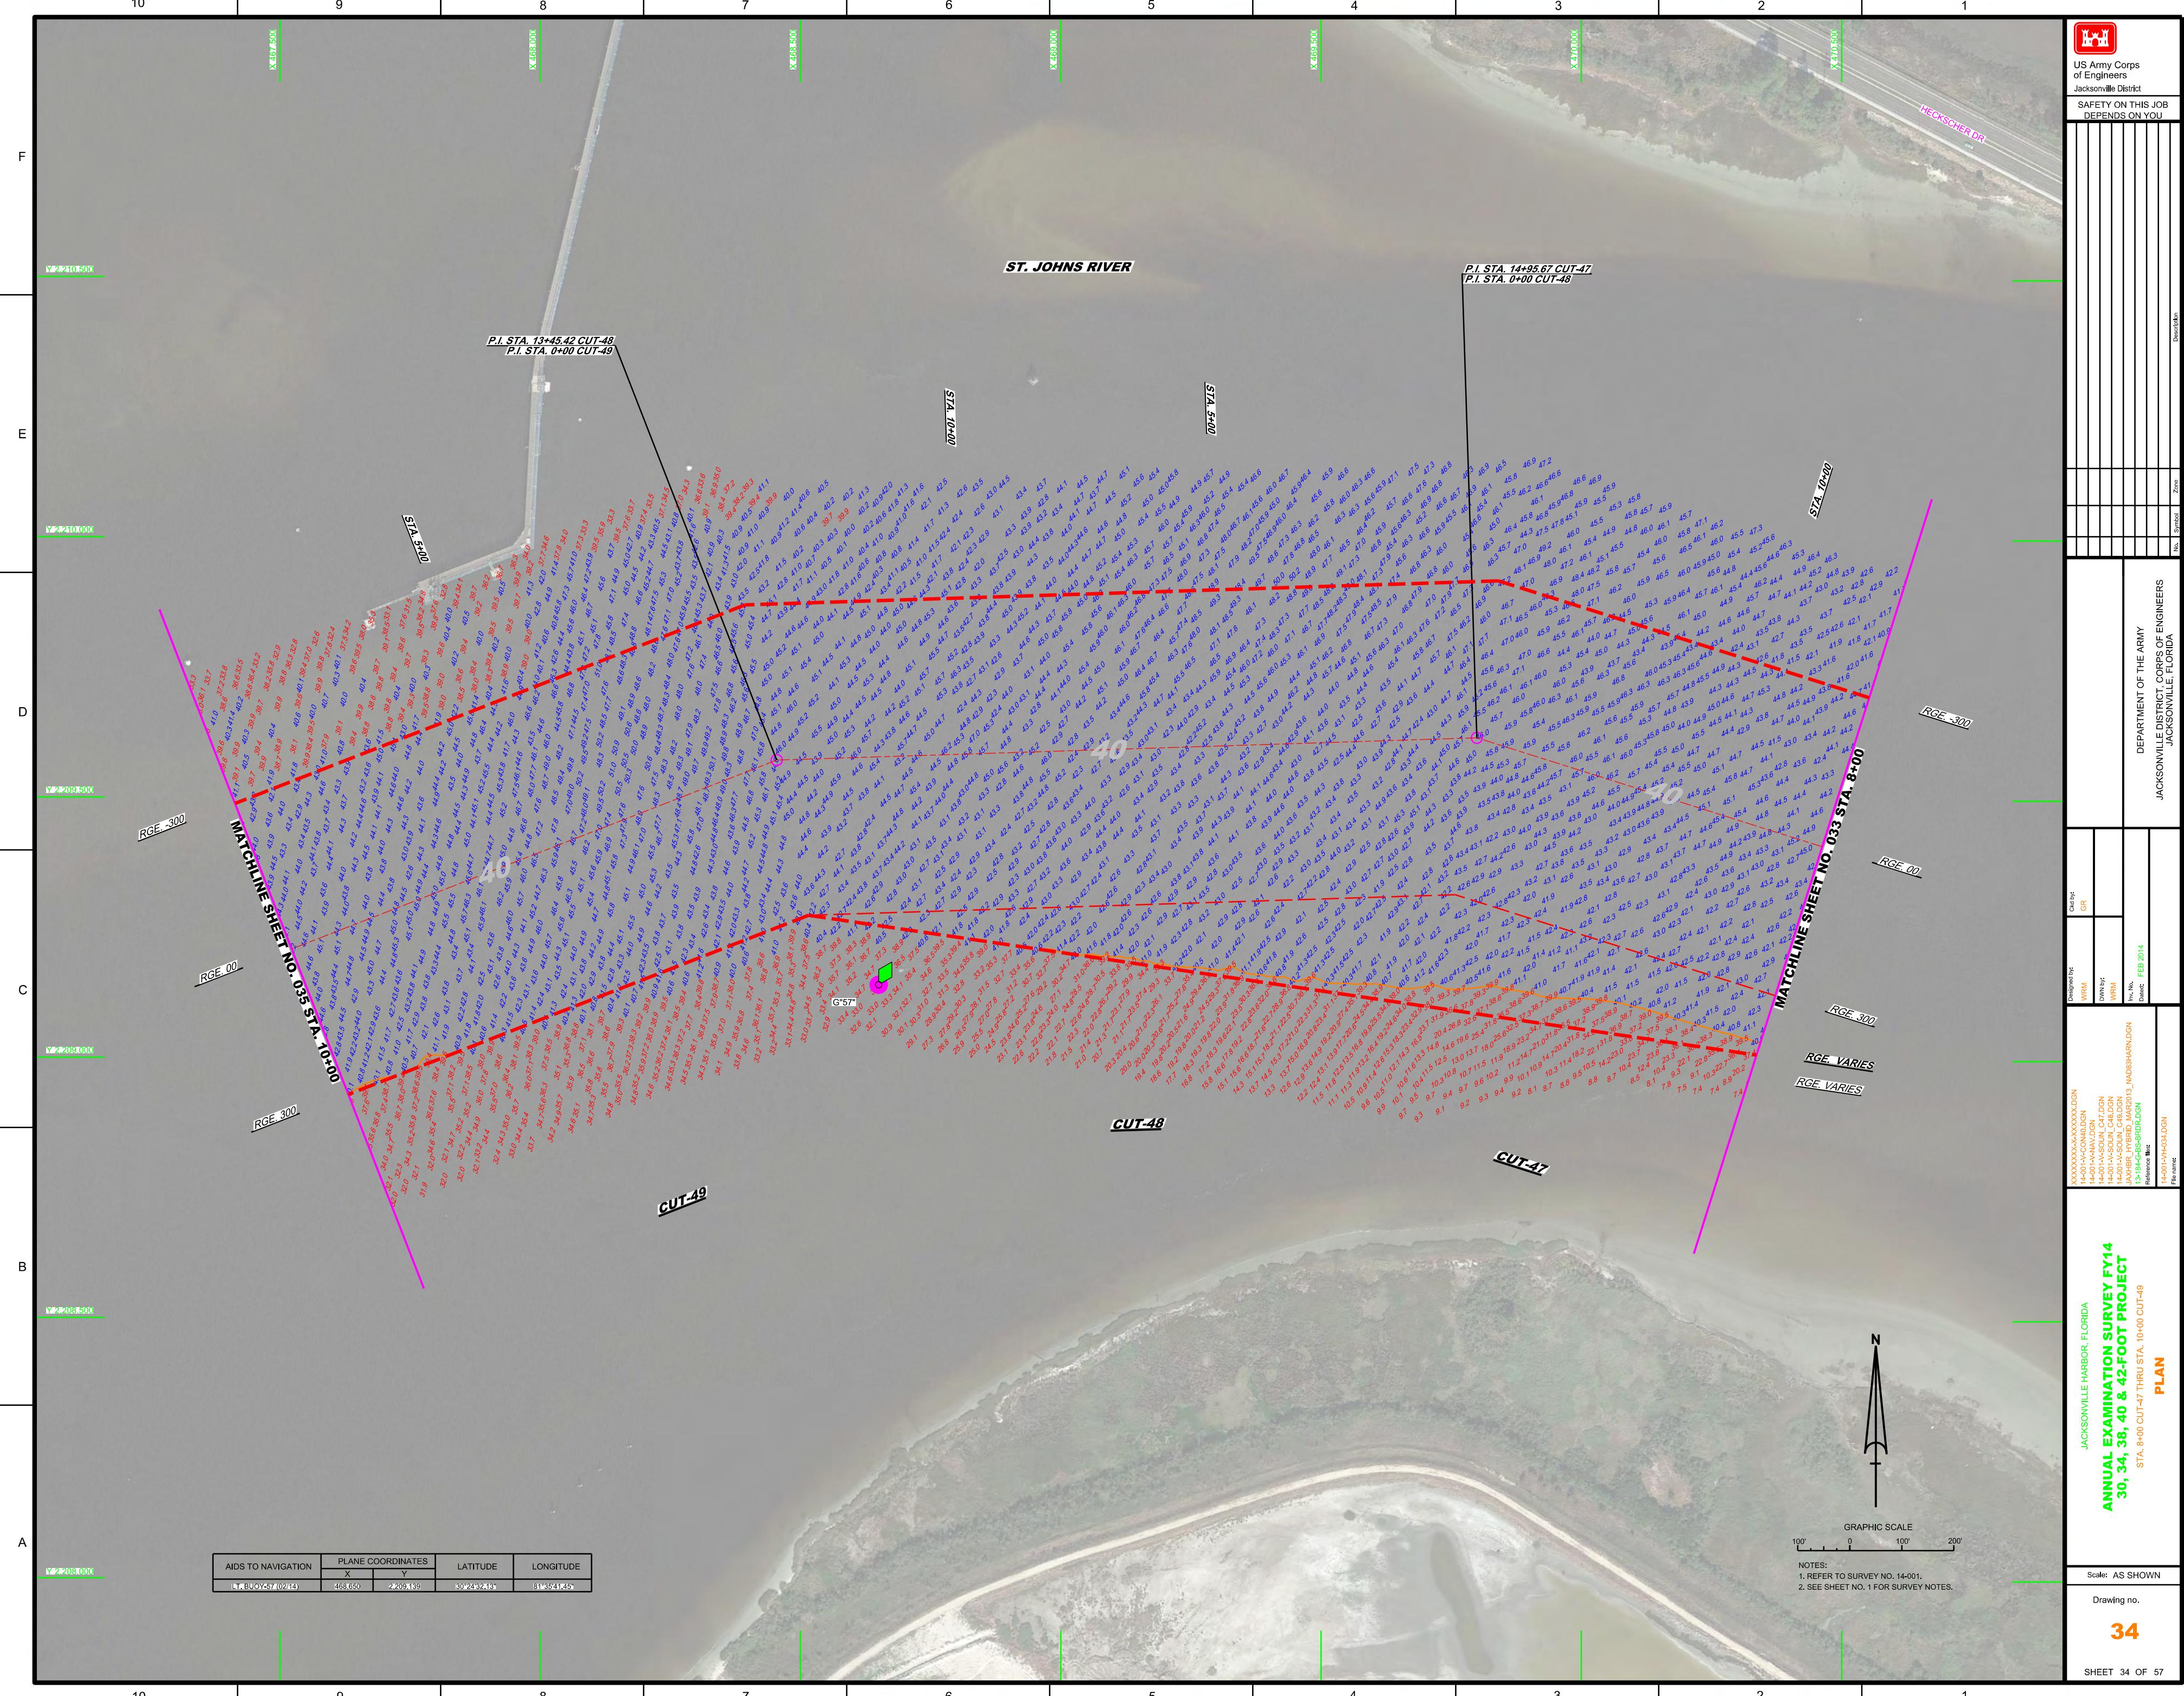



US Army Corps
of Engineers
Jacksonville District

SAFETY ON THIS JOB
DEPENDS ON YOU

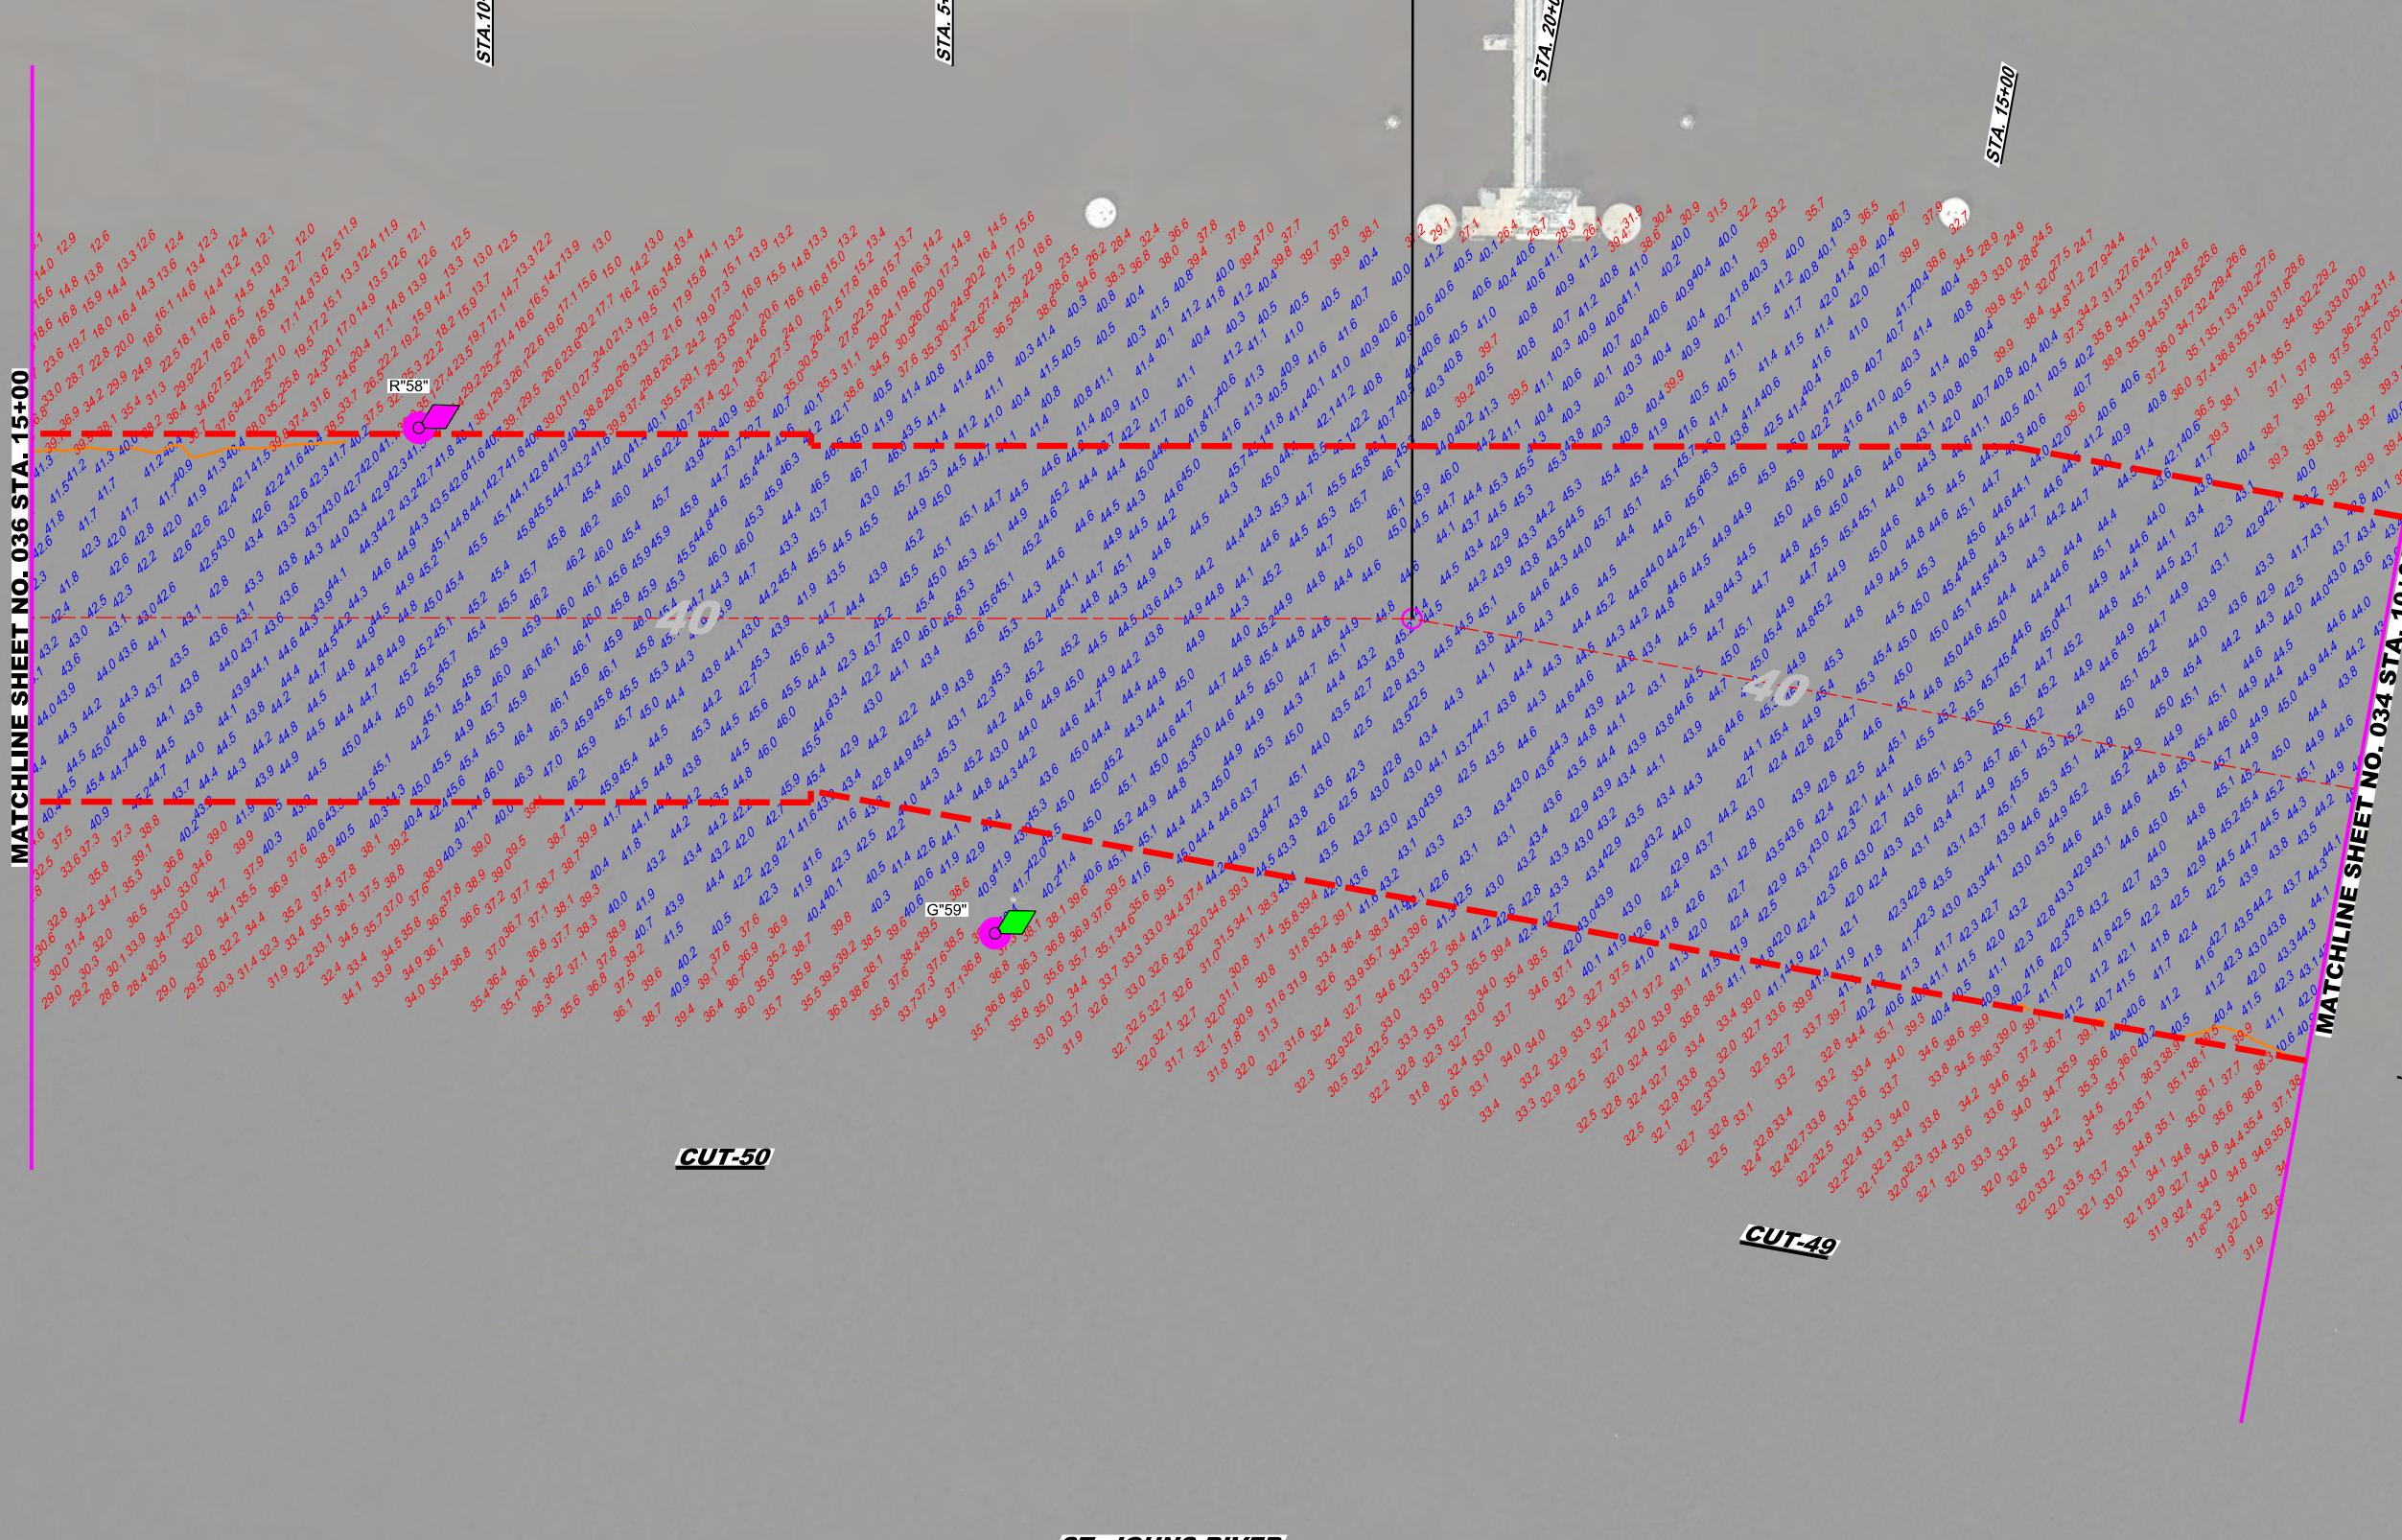

AIDS TO NAVIGATION	PLANE COORDINATES		LATITUDE	LONGITUDE
	X	Y		
L.BUOY58 (0214)	465,522	2,208,443	30°24'25.0"	81°36'17.12"
L.BUOY59 (0214)	466,344	2,208,301	30°24'23.74"	81°36'07.73"

GRAPHIC SCALE
100' 0 100' 200'

NOTES:
1. REFER TO SURVEY NO. 14-001.
2. SEE SHEET NO. 1 FOR SURVEY NOTES.

Scale: AS SHOWN
Drawing no.

35

SHEET 35 OF 57

JACKSONVILLE HARBOR, FLORIDA
ANNUAL EXAMINATION SURVEY FY14
30, 34, 38, 40 & 42-FOOT PROJECT
STA. 10+00 CUT-49 THRU STA. 15+00 CUT-50
PLAN

140-0100-00500N
File name:

140-0100-00500N
Reference file:

140-0100-00500N
Date:

140-0100-00500N
Page:

140-0100-00500N
Year:

140-0100-00500N
Month:

140-0100-00500N
Day:

140-0100-00500N
Hour:

140-0100-00500N
Minute:

140-0100-00500N
Second: