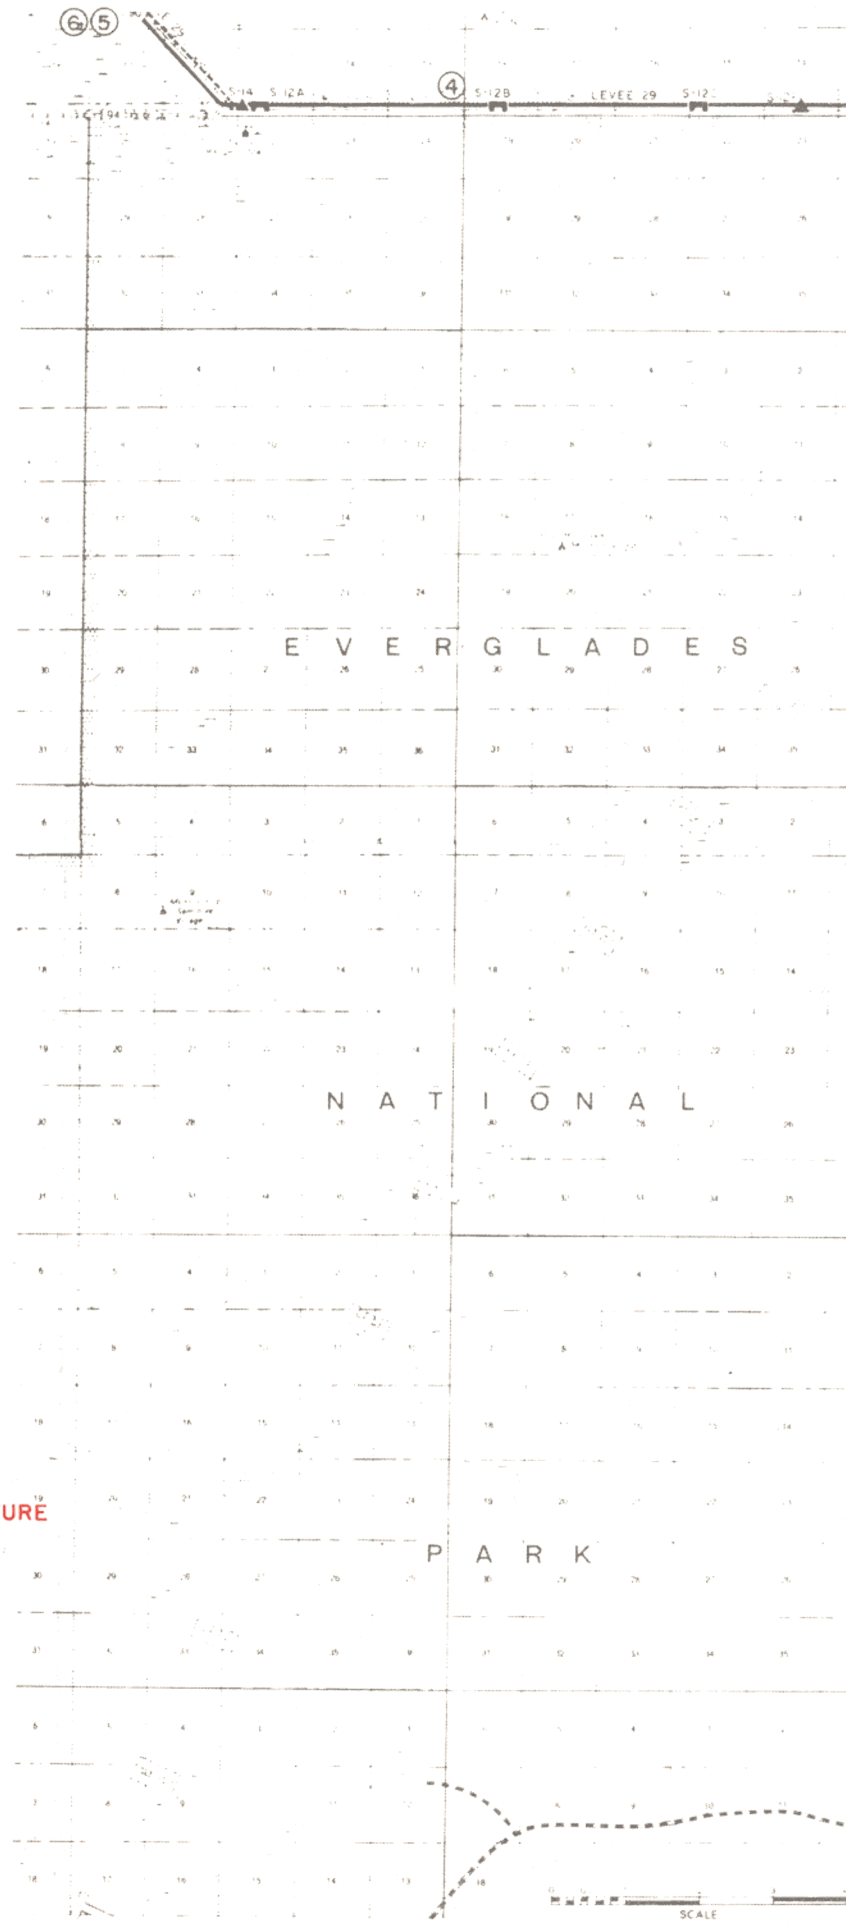

NEW AND MODIFIED WORKS FOR THIS PLAN ARE SHOWN IN RED

LEGEND

- MODIFIED STRUCTURE
- MODIFIED CANAL
- PUMP
- SPILLWAY
- CULVERT
- LEVEE
- CANAL
- INDIAN CAMP